



荒田 3047077 縮尺 1/600

No.51  
 $x = 1240.728$   
 $y = 924.497$


No.50  
 $x = 1265.493$   
 $y = 11799.562$

No.49  
 $x = 1265.788$   
 $y = 1019.046$


No.59  
 $x = 1231.103$   
 $y = 211022.240$

No.58  
 $x = 1203.131$   
 $y = 41967.192$

No.57  
 $x = 1189.794$   
 $y = 11940.254$

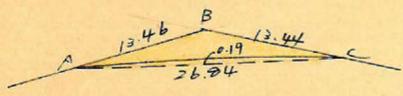


$\Delta ABC \text{ の } F = \frac{1}{2}(13.46 \times 13.44) \sin 0.172 = 0.1$   
 $= 12.55 \text{ m}^2$

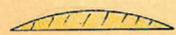

$\eta F = \frac{2}{3}(26.84 \times 0.19) = 3.40 \text{ m}^2$



$\eta F = 12.55 - 3.40 = 9.15 \text{ m}^2$

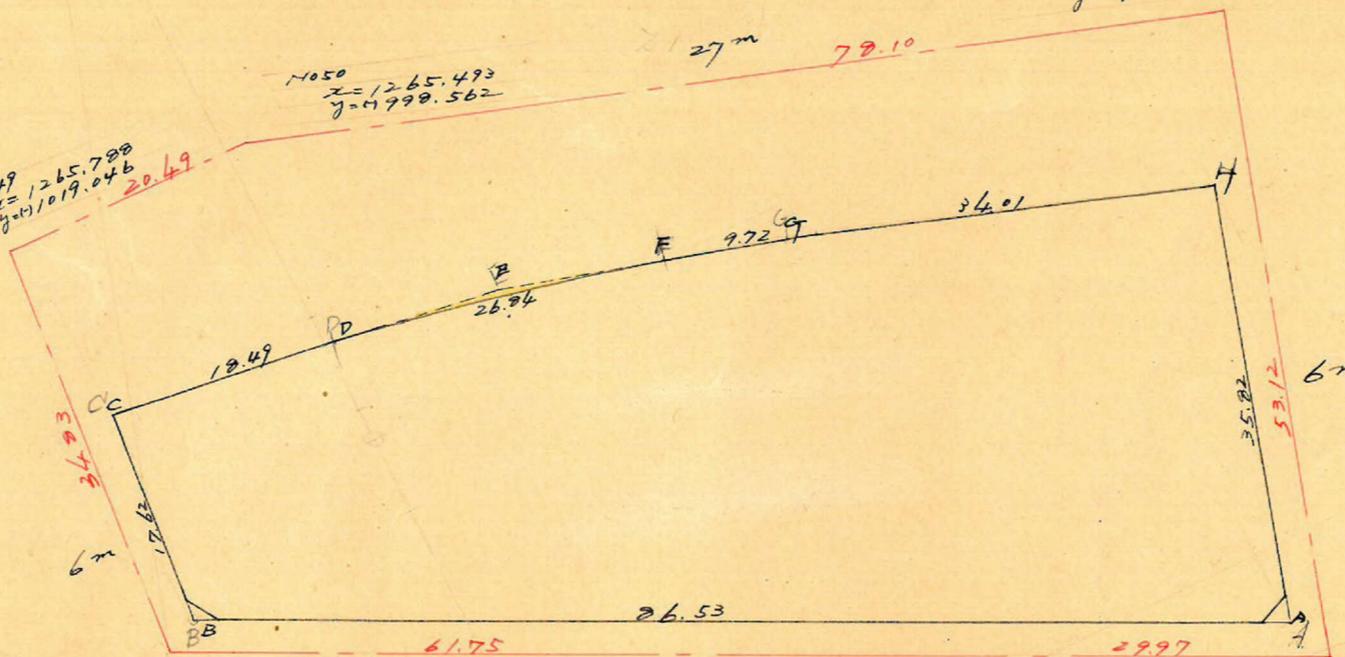

|   | 1         | 2        | 3        | 4         | 5        | 6        | 1 x 6         | 3 x 4       |
|---|-----------|----------|----------|-----------|----------|----------|---------------|-------------|
|   | x         | ax       |          | y         | ay       |          |               |             |
| A | 1,194.204 | + 38,778 |          | 942.018   | - 77,356 |          |               |             |
| B | 1,232,982 | + 17,522 | + 56,300 | 1,019,374 | + 1,250  | - 75,506 | - 93,097,539  | 57,390,756  |
| C | 1,250,504 | - 2,603  | + 14,919 | 1,017,524 | + 18,301 | + 20,151 | + 25,198,906  | 15,180,441  |
| D | 1,247,901 | - 2,019  | - 4,622  | 999,223   | + 13,307 | + 31,608 | + 39,443,655  | 4,618,409   |
| E | 1,245,882 | - 3,816  | - 5,835  | 985,916   | + 12,887 | + 26,194 | + 32,634,633  | 5,752,820   |
| F | 1,242,066 | - 2,725  | - 6,541  | 973,029   | + 9,327  | + 22,214 | + 27,591,254  | 6,364,583   |
| G | 1,239,341 | - 10,904 | - 13,629 | 963,702   | + 32,215 | + 41,542 | + 51,484,704  | 13,134,295  |
| H | 1,228,437 | - 34,233 | - 45,137 | 931,487   | + 10,531 | + 21,684 | + 26,637,428  | 42,044,529  |
| A | 1,194,204 | + 38,778 | + 4,545  | 942,018   | - 77,356 | - 87,887 | - 104,955,007 | 14,281,472  |
|   |           |          |          |           |          |          | + 4,938,034   | - 4,938,033 |

$\frac{\text{m}^2}{2} = 2.469.02 \text{ m}^2$

合計面積  $2.469.02 \text{ m}^2 - 9.15 \text{ m}^2 = 2459.87 \text{ m}^2$  ( $\times 0.3025 = 744.11 \text{ 坪}$ ) = 744.09 坪  
 剪除 "  $1.50 + 2.40 = 3.90$  " ( $\times " = 1.17$ ) = 1.17 "   
 割込 " = 742.92 "

この図面等は、土地区画整理事業に関する参考資料として提供しています。  
 ○図面等は換地処分時のものであり、現在の状況とは異なる場合があります。  
 ○図面等によって、境界等が確定されるものではありません。