

課長	係長	測量士	係



(分筆前)
確定面積平面図 $S = \frac{1}{600}$

ブロック番号 養

322号

新地名 町 丁目

44年2月13日 修

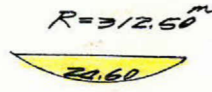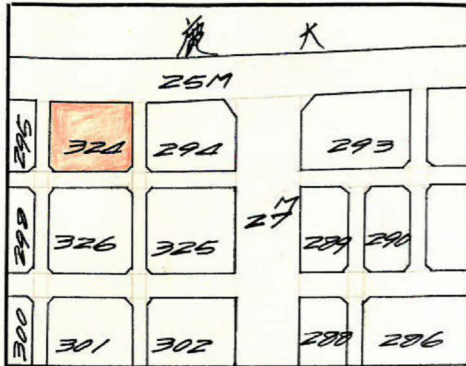

$$\theta = \frac{360 \times 24.60}{2 \times 312.50 \times 3.1416} = 4.51031 = 2^\circ 30' - 37''$$


$$\sin 2^\circ 15' 18'' (0.039347) \times 312.50 = 12.296m$$

$$\cos \quad \quad (0.9992256) \times 312.50 = 312.258m$$

$$\frac{312.50^2 \times 3.1416 \times 4.51031}{360} = 3803.707m^2$$

$$12.296 \times 312.258 = 3839.521m^2$$

$$\text{面積} = 3803.707m^2 - 3839.521m^2 = -35.814m^2$$

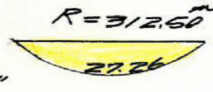

$$\theta = \frac{360 \times 27.26}{2 \times 312.50 \times 3.1416} = 4.99801 = 2^\circ 59' - 53''$$




$$\sin 2^\circ 29' 56'' (0.04336) \times 312.50 = 13.625m$$

$$\cos \quad \quad (0.9990890) \times 312.50 = 312.203m$$

$$\frac{312.50^2 \times 3.1416 \times 4.99801}{360} = 4259.372m^2$$


$$13.625 \times 312.203 = 4253.766m^2$$

$$\text{面積} = 4259.372m^2 - 4253.766m^2 = 5.606m^2$$

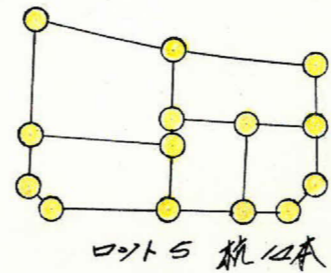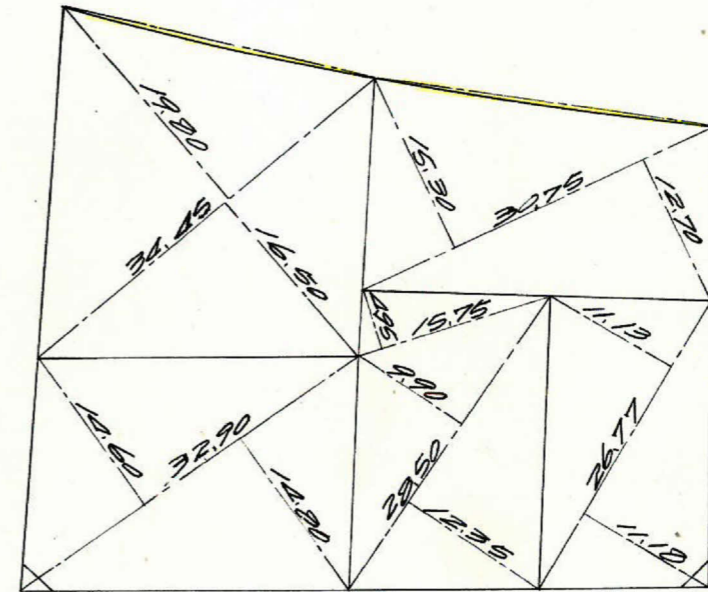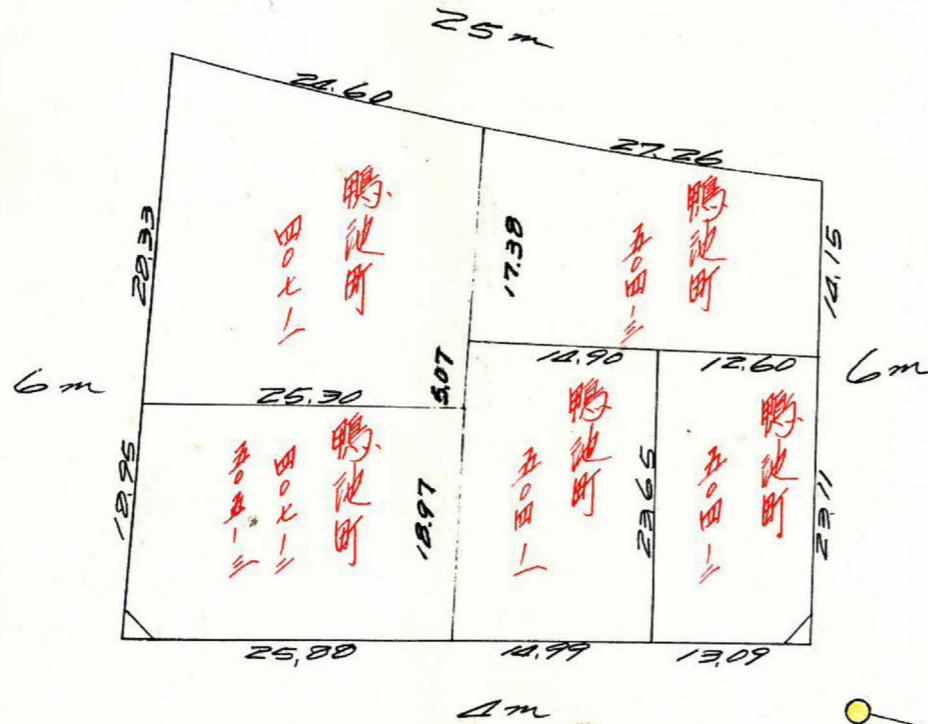

この図面等は、土地区画整理事業に関する参考資料として提供しています。
 ○図面等は換地処分時のものであり、現在の状況とは異なる場合があります。
 ○図面等によって、境界等が確定されるものではありません。


この図面等は、土地区画整理事業に関する参考資料として提供しています。
 ○図面等は換地処分時のものであり、現在の状況とは異なる場合があります。
 ○図面等によって、境界等が確定されるものではありません。

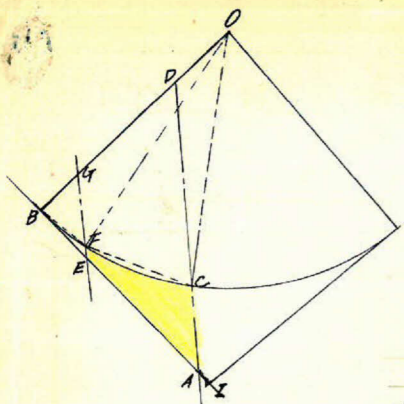

$IA = 23^{\circ} - 02' - 13''$
 $R = 312.50m$
 $TL = 65.58m$
 $CL = 129.28m$
 $AL = 6.81m$


$AB = 65.58 \times 0.73 = 64.85m$
 $\angle BAD = 73^{\circ} - 18' - 46''$
 $BD = \tan 73^{\circ} - 18' - 46'' (3.3758769) \times 64.85 = 216.33m$
 $AD = \sec 73^{\circ} - 18' - 46'' (3.4825386) \times 64.85 = 225.84m$
 $DO = 312.50 - 216.33 = 96.17m$

$\angle APB = (180^{\circ} - 00' - 00') - (90^{\circ} - 00' - 00') - (73^{\circ} - 18' - 46'') = 16^{\circ} - 01' - 14''$
 $\angle CDO = (180^{\circ} - 00' - 00') - (16^{\circ} - 01' - 14'') = 163^{\circ} - 18' - 46''$
 $\sin \angle DCO = \frac{96.17 \times \sin(163^{\circ} - 18' - 46'')}{312.50} = 0.0893677$
 $\angle DCO = 5^{\circ} - 02' - 11''$
 $\angle DDC = (180^{\circ} - 00' - 00') - (163^{\circ} - 18' - 46'') - (5^{\circ} - 02' - 11'') = 11^{\circ} - 37' - 03''$
 $DC = \sqrt{312.50^2 + 96.17^2} - 2 \times 312.50 \times 96.17 \times \cos 11^{\circ} - 37' - 03'' = 219.16m$
 $CA = 225.84m - 219.16m = 6.68m$
 $BC = \{ \frac{1}{2} \sin 11^{\circ} - 37' - 03'' (0.1998653) \} \times 312.50 \times 2 = 63.26m$

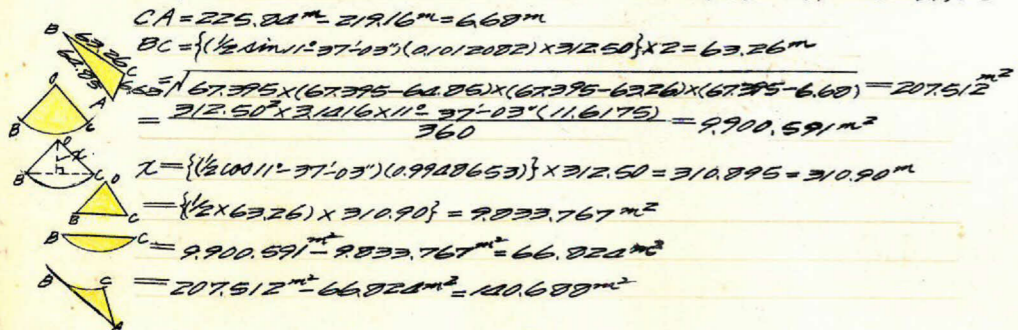

$\frac{1}{2} \times 67.395 \times (67.395 - 64.85) \times (67.395 - 64.85) \times (67.395 - 6.68) = 207.512$
 $= \frac{312.50 \times 3.416 \times 11^{\circ} - 37' - 03'' (11.6175)}{360} = 9,900.591 m^2$
 $\lambda = \{ \frac{1}{2} \cos 11^{\circ} - 37' - 03'' (0.9998653) \} \times 312.50 = 310.895 = 310.90m$
 $= \{ \frac{1}{2} \times 63.26 \} \times 310.90 = 9,833.767 m^2$
 $C = 9,900.591 - 9,833.767 = 66.824 m^2$
 $B = 207.512 - 66.824 = 140.688 m^2$


$BE = 65.58 - 0.73 - 53.21 = 11.64m$
 $\angle BEF = 76^{\circ} - 56' - 21''$
 $Bq = \tan 76^{\circ} - 56' - 21'' (4.3105917) \times 11.64 = 50.175 = 50.18m$
 $Eg = \sec 76^{\circ} - 56' - 21'' (4.0250651) \times 11.64 = 51.51m$
 $qo = 312.50 - 50.18 = 262.32m$
 $\angle EQB = (180^{\circ} - 00' - 00') - (90^{\circ} - 00' - 00') - (76^{\circ} - 56' - 21'') = 13^{\circ} - 03' - 39''$
 $\angle EQO = (180^{\circ} - 00' - 00') - (13^{\circ} - 03' - 39'') = 166^{\circ} - 56' - 21''$
 $\sin \angle QFO = \frac{262.32 \times \sin(166^{\circ} - 56' - 21'')}{312.50} = 0.1096976$
 $\angle QFO = 10^{\circ} - 57' - 06''$
 $\angle QOF = (180^{\circ} - 00' - 00') - (166^{\circ} - 56' - 21'') - (10^{\circ} - 57' - 06'') = 2^{\circ} - 06' - 33''$
 $Fq = \sqrt{312.50^2 + 262.32^2} - 2 \times 312.50 \times 262.32 \times \cos 2^{\circ} - 06' - 33'' = 61.27m$
 $ff = 51.51 - 61.27 = 0.24m$
 $BF = \{ \frac{1}{2} \sin 2^{\circ} - 06' - 33'' (0.0180009) \} \times 312.50 \times 2 = 11.50m$

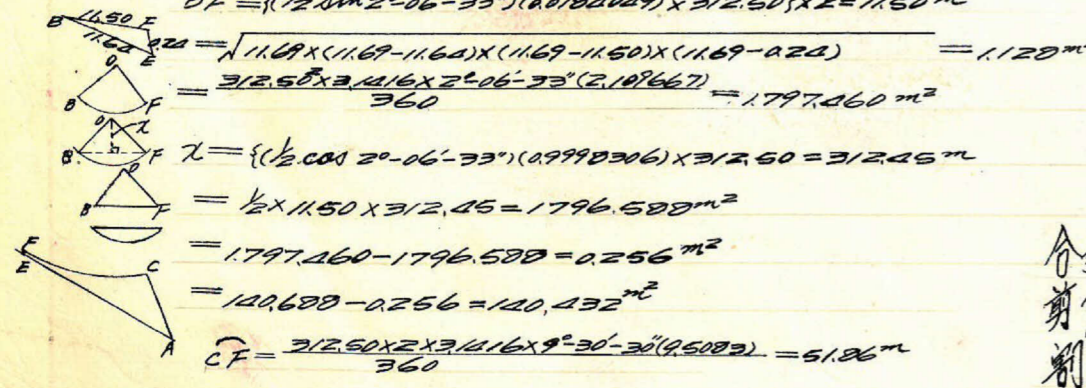

$\frac{1}{2} \times 11.50 \times 0.24 = 1.129 m^2$
 $= \frac{312.50 \times 3.416 \times 2^{\circ} - 06' - 33'' (2.107667)}{360} = 1,797.060 m^2$
 $\lambda = \{ \frac{1}{2} \cos 2^{\circ} - 06' - 33'' (0.9998306) \} \times 312.50 = 312.45m$
 $= \frac{1}{2} \times 11.50 \times 312.45 = 1,796.588 m^2$
 $= 1,797.060 - 1,796.588 = 0.256 m^2$
 $= 140.688 - 0.256 = 140.432 m^2$
 $CF = \frac{312.50 \times 2 \times 3.416 \times 9^{\circ} - 30' - 30'' (0.5083)}{360} = 51.86m$

合計面積
 剪除
 割込

$1,219,173 m^2 + 822,883 m^2 - 1,172 m^2 + 0.931 m^2 + 140,432 m^2 = 2,181,247 m^2 (\times 0.3025 = 660,734)$
 $2.36 + 2.26 = 4.62 m^2 (" = 1.39)$
 $2,179,627 m^2 (" = 65,33)$

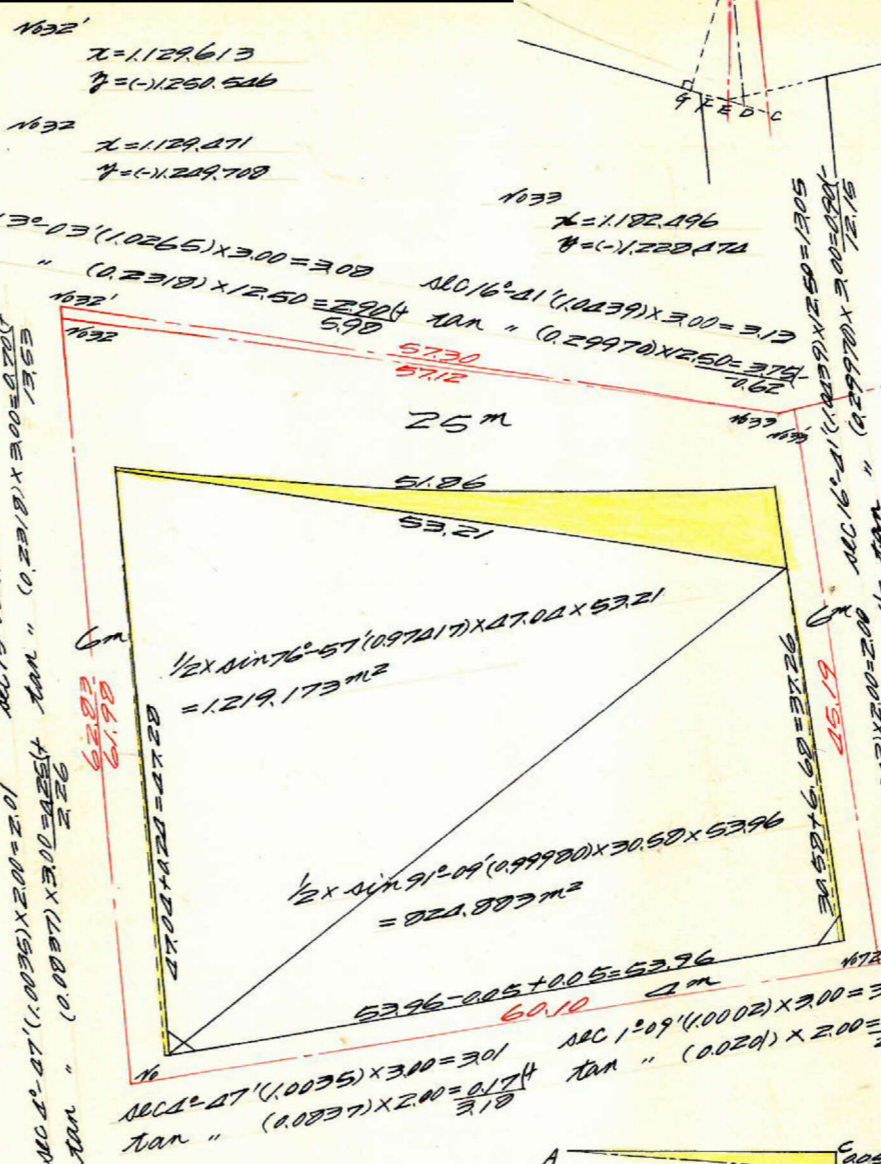


$Aq = 12.50m$
 $\angle ABC = 106^{\circ} - 01' - 18''$
 $Cf = \sec 16^{\circ} - 01' - 18'' (1.027965) \times 3.00 = 3.13m$
 $Dg = \tan " (0.2997713) \times 12.50 = 3.75$
 $\angle GAE = 11^{\circ} - 51' - 07''$
 $Eg = \tan 11^{\circ} - 51' - 07'' (0.2098572) \times 12.50 = 2.62$
 $EF = 3.13 - (3.75 - 2.62) - 1.27 = 0.73m$

$\angle BAC = 23^{\circ} - 02' - 13''$
 $\angle ABC = 92^{\circ} - 59' - 01''$
 $\angle ACD = 73^{\circ} - 18' - 46''$
 $AB = 1.229m$
 $BC = \frac{\sin 23^{\circ} - 02' - 13'' (0.3920035) \times 1.229}{\sin 73^{\circ} - 18' - 46'' (0.9578865)} = 0.516$
 $AC = \sqrt{1.229^2 + 0.516^2} - 2 \times 1.229 \times 0.516 \times \cos 92^{\circ} - 59' - 01'' = 1.776697$
 $= 1.268328 \times 0.1221633 = 1.273$



$\lambda = 1.193,725$
 $\eta = (-) \times 1,228,498$

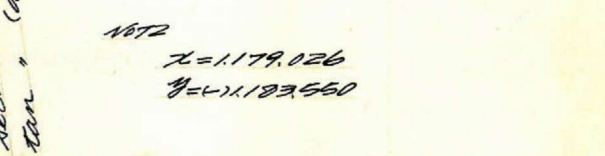

$\lambda = 1.179,026$
 $\eta = (-) \times 1,193,560$

$\angle ABC = 86^{\circ} - 13'$
 $AC = \sqrt{27.02^2 + 0.05^2} - 2 \times 27.02 \times 0.05 \times \cos 86^{\circ} - 13' (0.08339) = 27.02m$
 $F = \frac{1}{2} \times \{ (27.02 \times 0.05) \times \sin 86^{\circ} - 13' (0.99652) \} = 1.172 m^2$
 $\angle ABC = 91^{\circ} - 09'$
 $AC = \sqrt{37.26^2 + 0.05^2} - 2 \times 37.26 \times 0.05 \times \cos 91^{\circ} - 09' (0.02007) = 37.26$
 $F = \frac{1}{2} \times \{ (37.26 \times 0.05) \times \sin 91^{\circ} - 09' (0.99989) \} = 0.931 m^2$