


# 原良第三地区土地区画整理事業 出来形確認測量図

17 BL


薬師二丁目 22

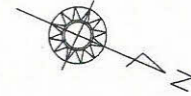

53	0.995	0.497
54	10.50m	
55	10.555	5.24m
64	10.558	10.554
63	0.995	0.496

56	1.383	0.480
57	10.546	14.58m
58	10.546	5.06m
61	10.546	10.546
60	1.382	0.480

47	13.624	78.075	74
46	3.72m		75
45	13.699	0.70m	76
44	13.698	30.44m	77
	2.222	13.697	

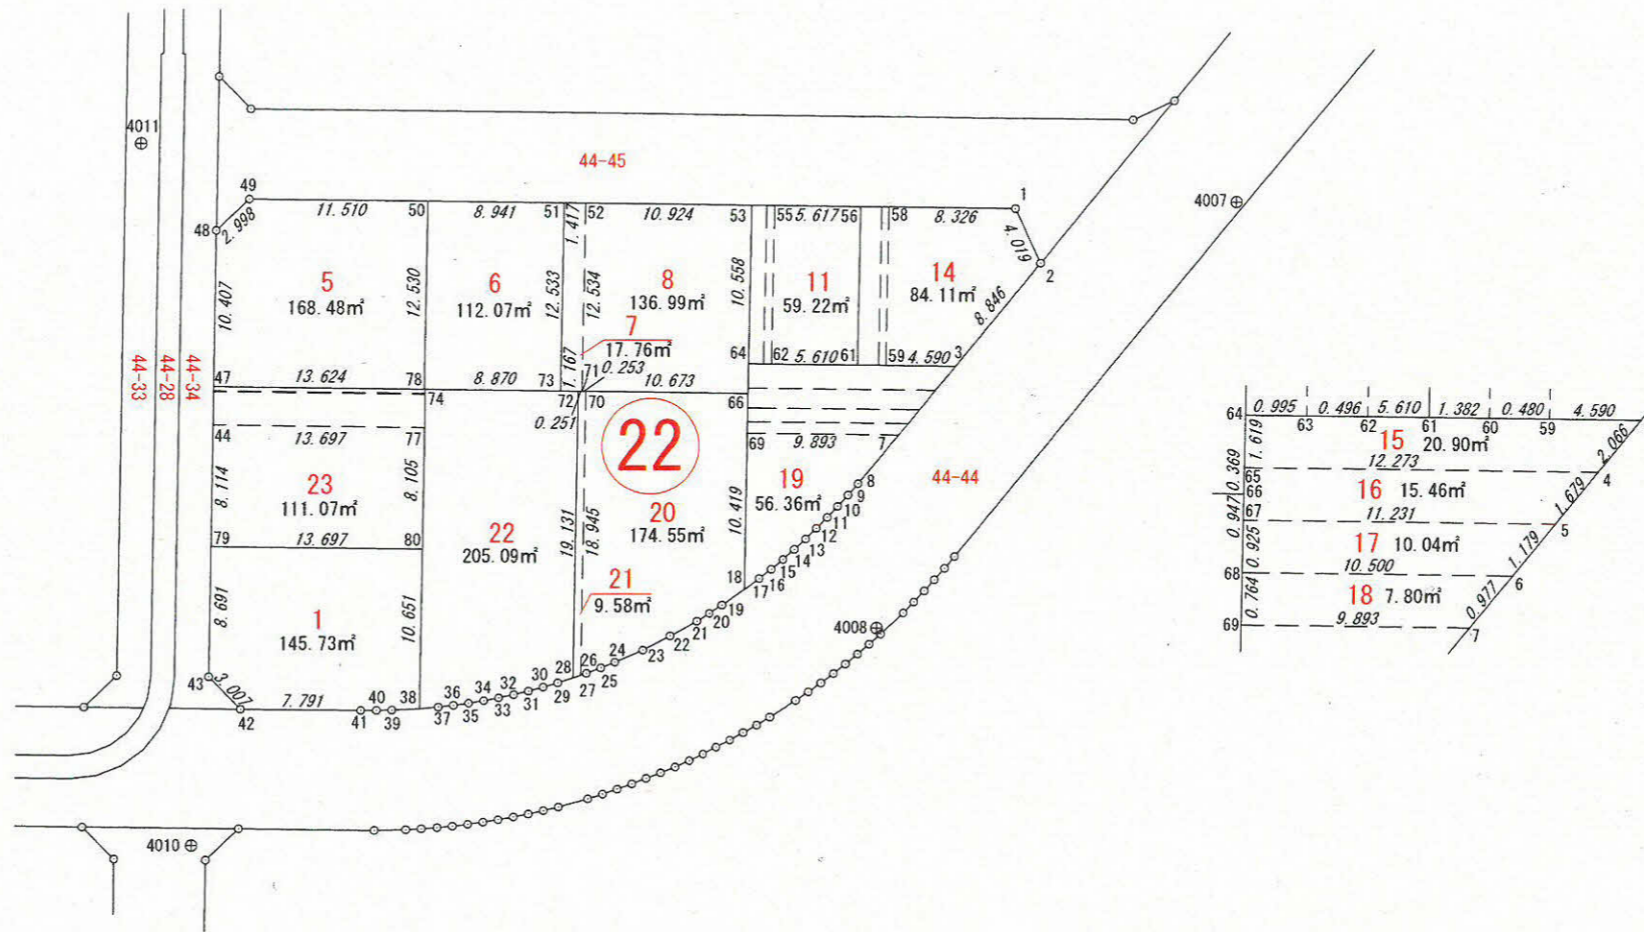

64	0.995	0.496	5.610	1.382	0.480	4.590
63						
62			20.90m			
61			12.273			
60						
59						
58			15.46m			
57			11.231			
56						
55			10.04m			
54			10.500			
53			7.80m			
52			9.893			
51						
50						
49						
48						
47						
46						
45						
44						

距離表

17-3	2.066
17-4	1.679
17-5	1.179
17-6	0.977
17-7	4.178
17-8	1.000
17-9	1.005
17-10	1.000
17-11	1.006
17-12	1.006
17-13	1.003
17-14	1.004
17-15	1.006
17-16	1.005
17-17	1.205
17-18	1.803
17-19	1.001
17-20	1.005
17-21	2.009
17-22	2.007
17-23	2.005
17-24	0.998
17-25	1.008
17-26	0.405
17-27	0.536
17-28	1.056
17-29	1.003
17-30	1.004
17-31	1.004
17-32	0.998
17-33	1.004
17-34	1.009
17-35	1.002
17-36	0.996
17-37	1.224
17-38	1.784
17-39	1.006
17-40	1.006
17-41	1.006

この図面等は、土地区画整理事業に関する参考資料として提供しています。  
 ○図面等は換地処分時のものであり、現在の状況とは異なる場合があります。  
 ○図面等によって、境界等が確定されるものではありません。

縮尺 1/500